



DRAWING NUMBER
A-105
CANTOR FITZGERALD
105P-9 # 1-B-2-91

DRAWING NUMBER
A-105
CANTOR FITZGERALD
105P-9 # 1-B-2-91

DRAWING NUMBER
A-105
CANTOR FITZGERALD
105P-9 # 1-B-2-91

DRAWING NUMBER
A-105
CANTOR FITZGERALD
105P-9 # 1-B-2-91

IF THIS DRAWING IS NOT 24" x 36" IT IS A REDUCED PRINT SCALE ACCORDINGLY

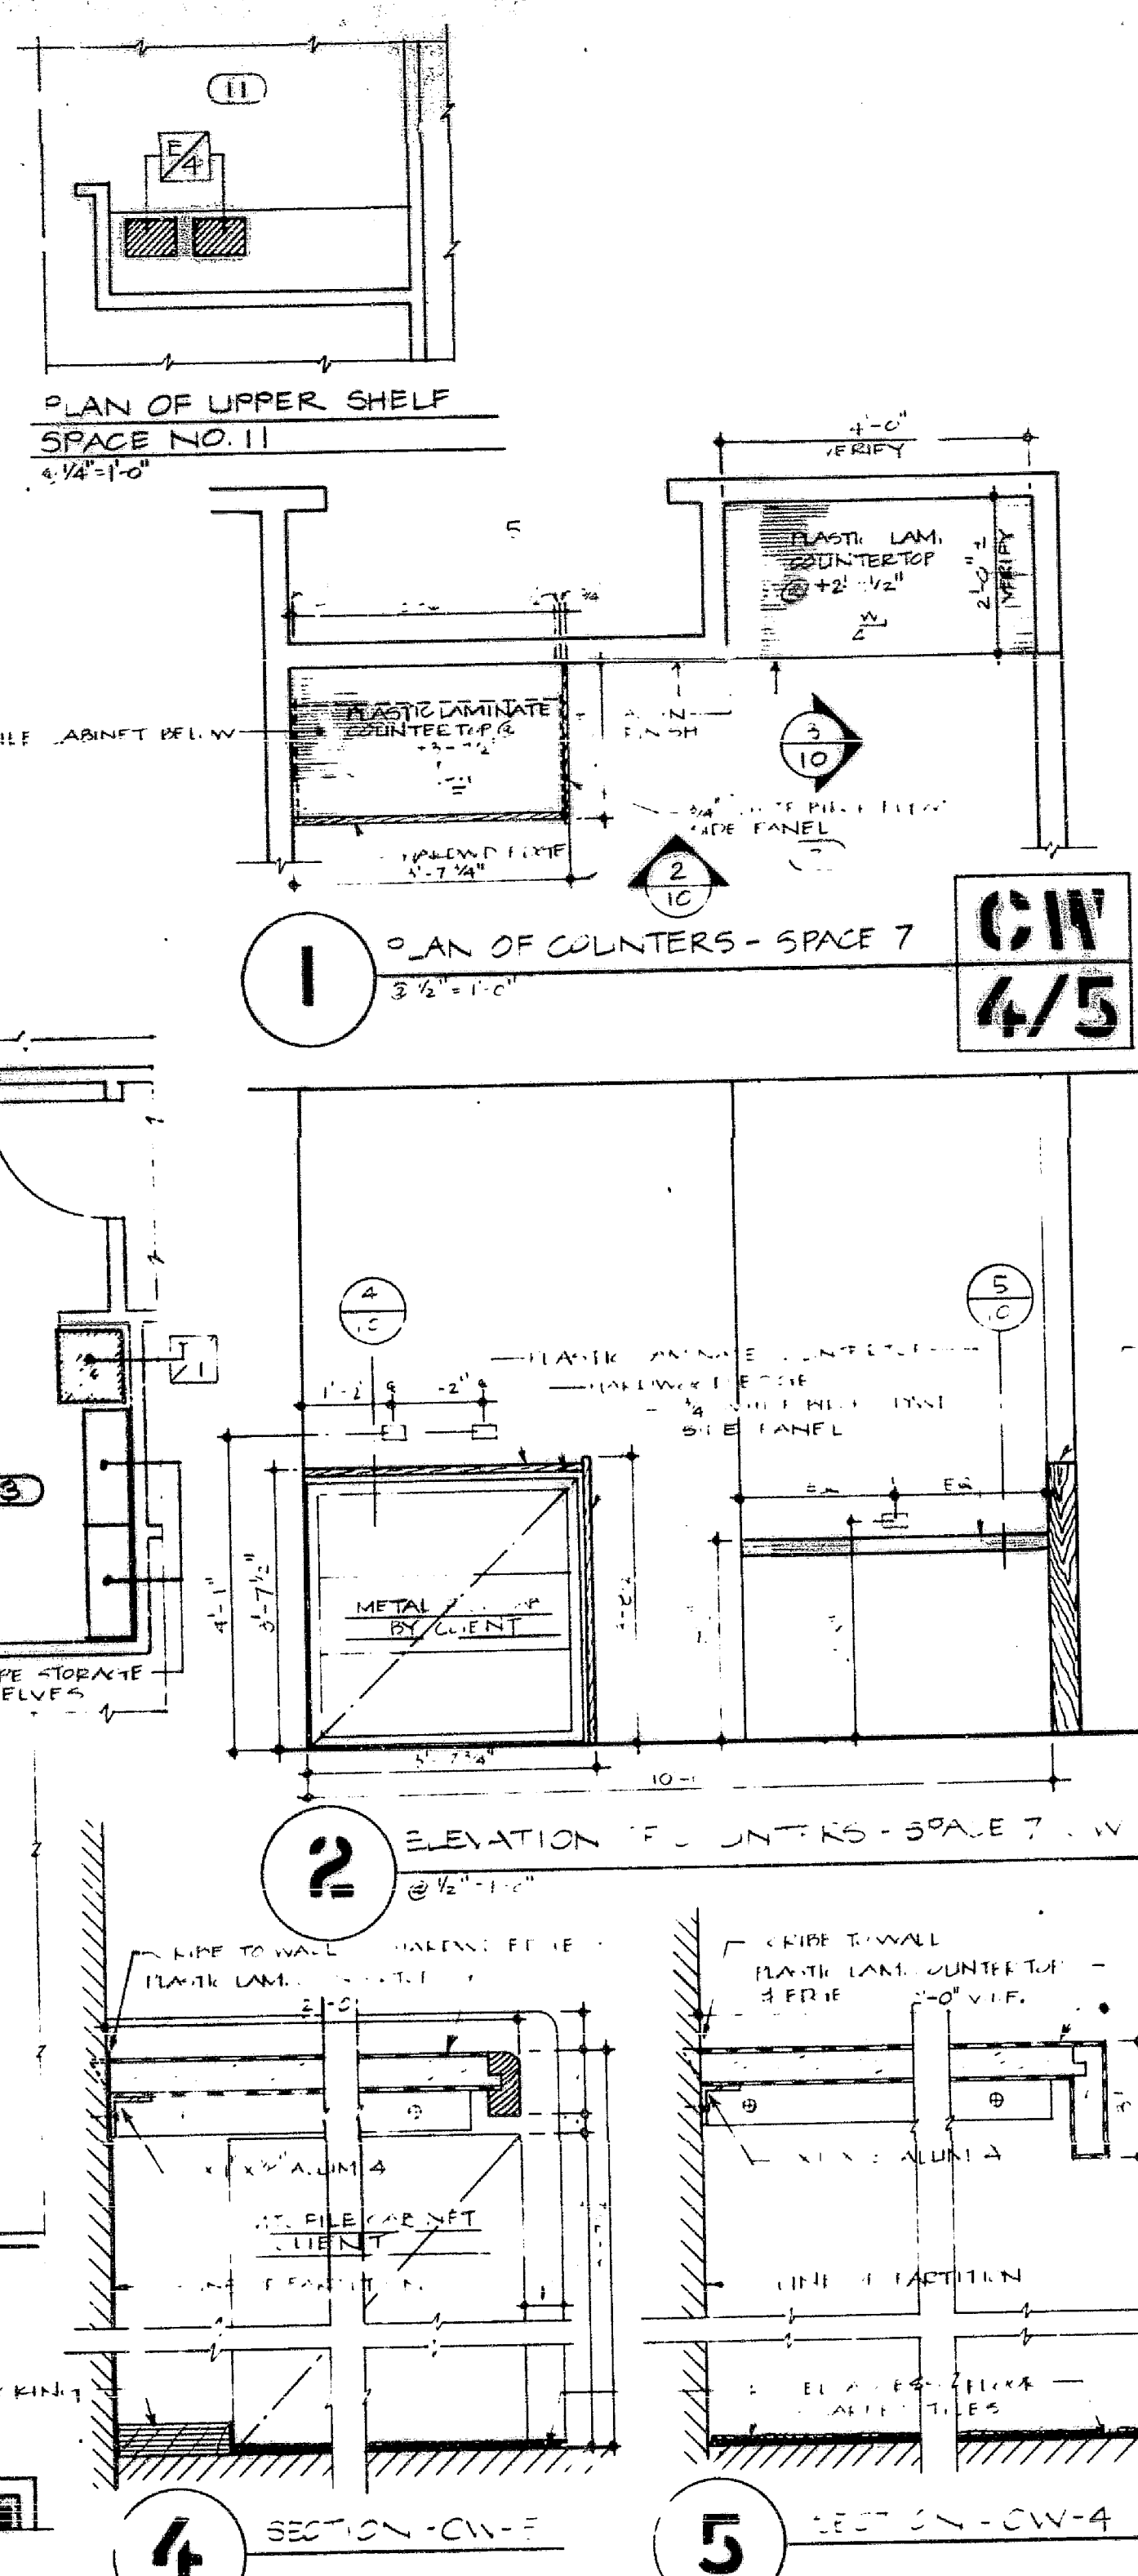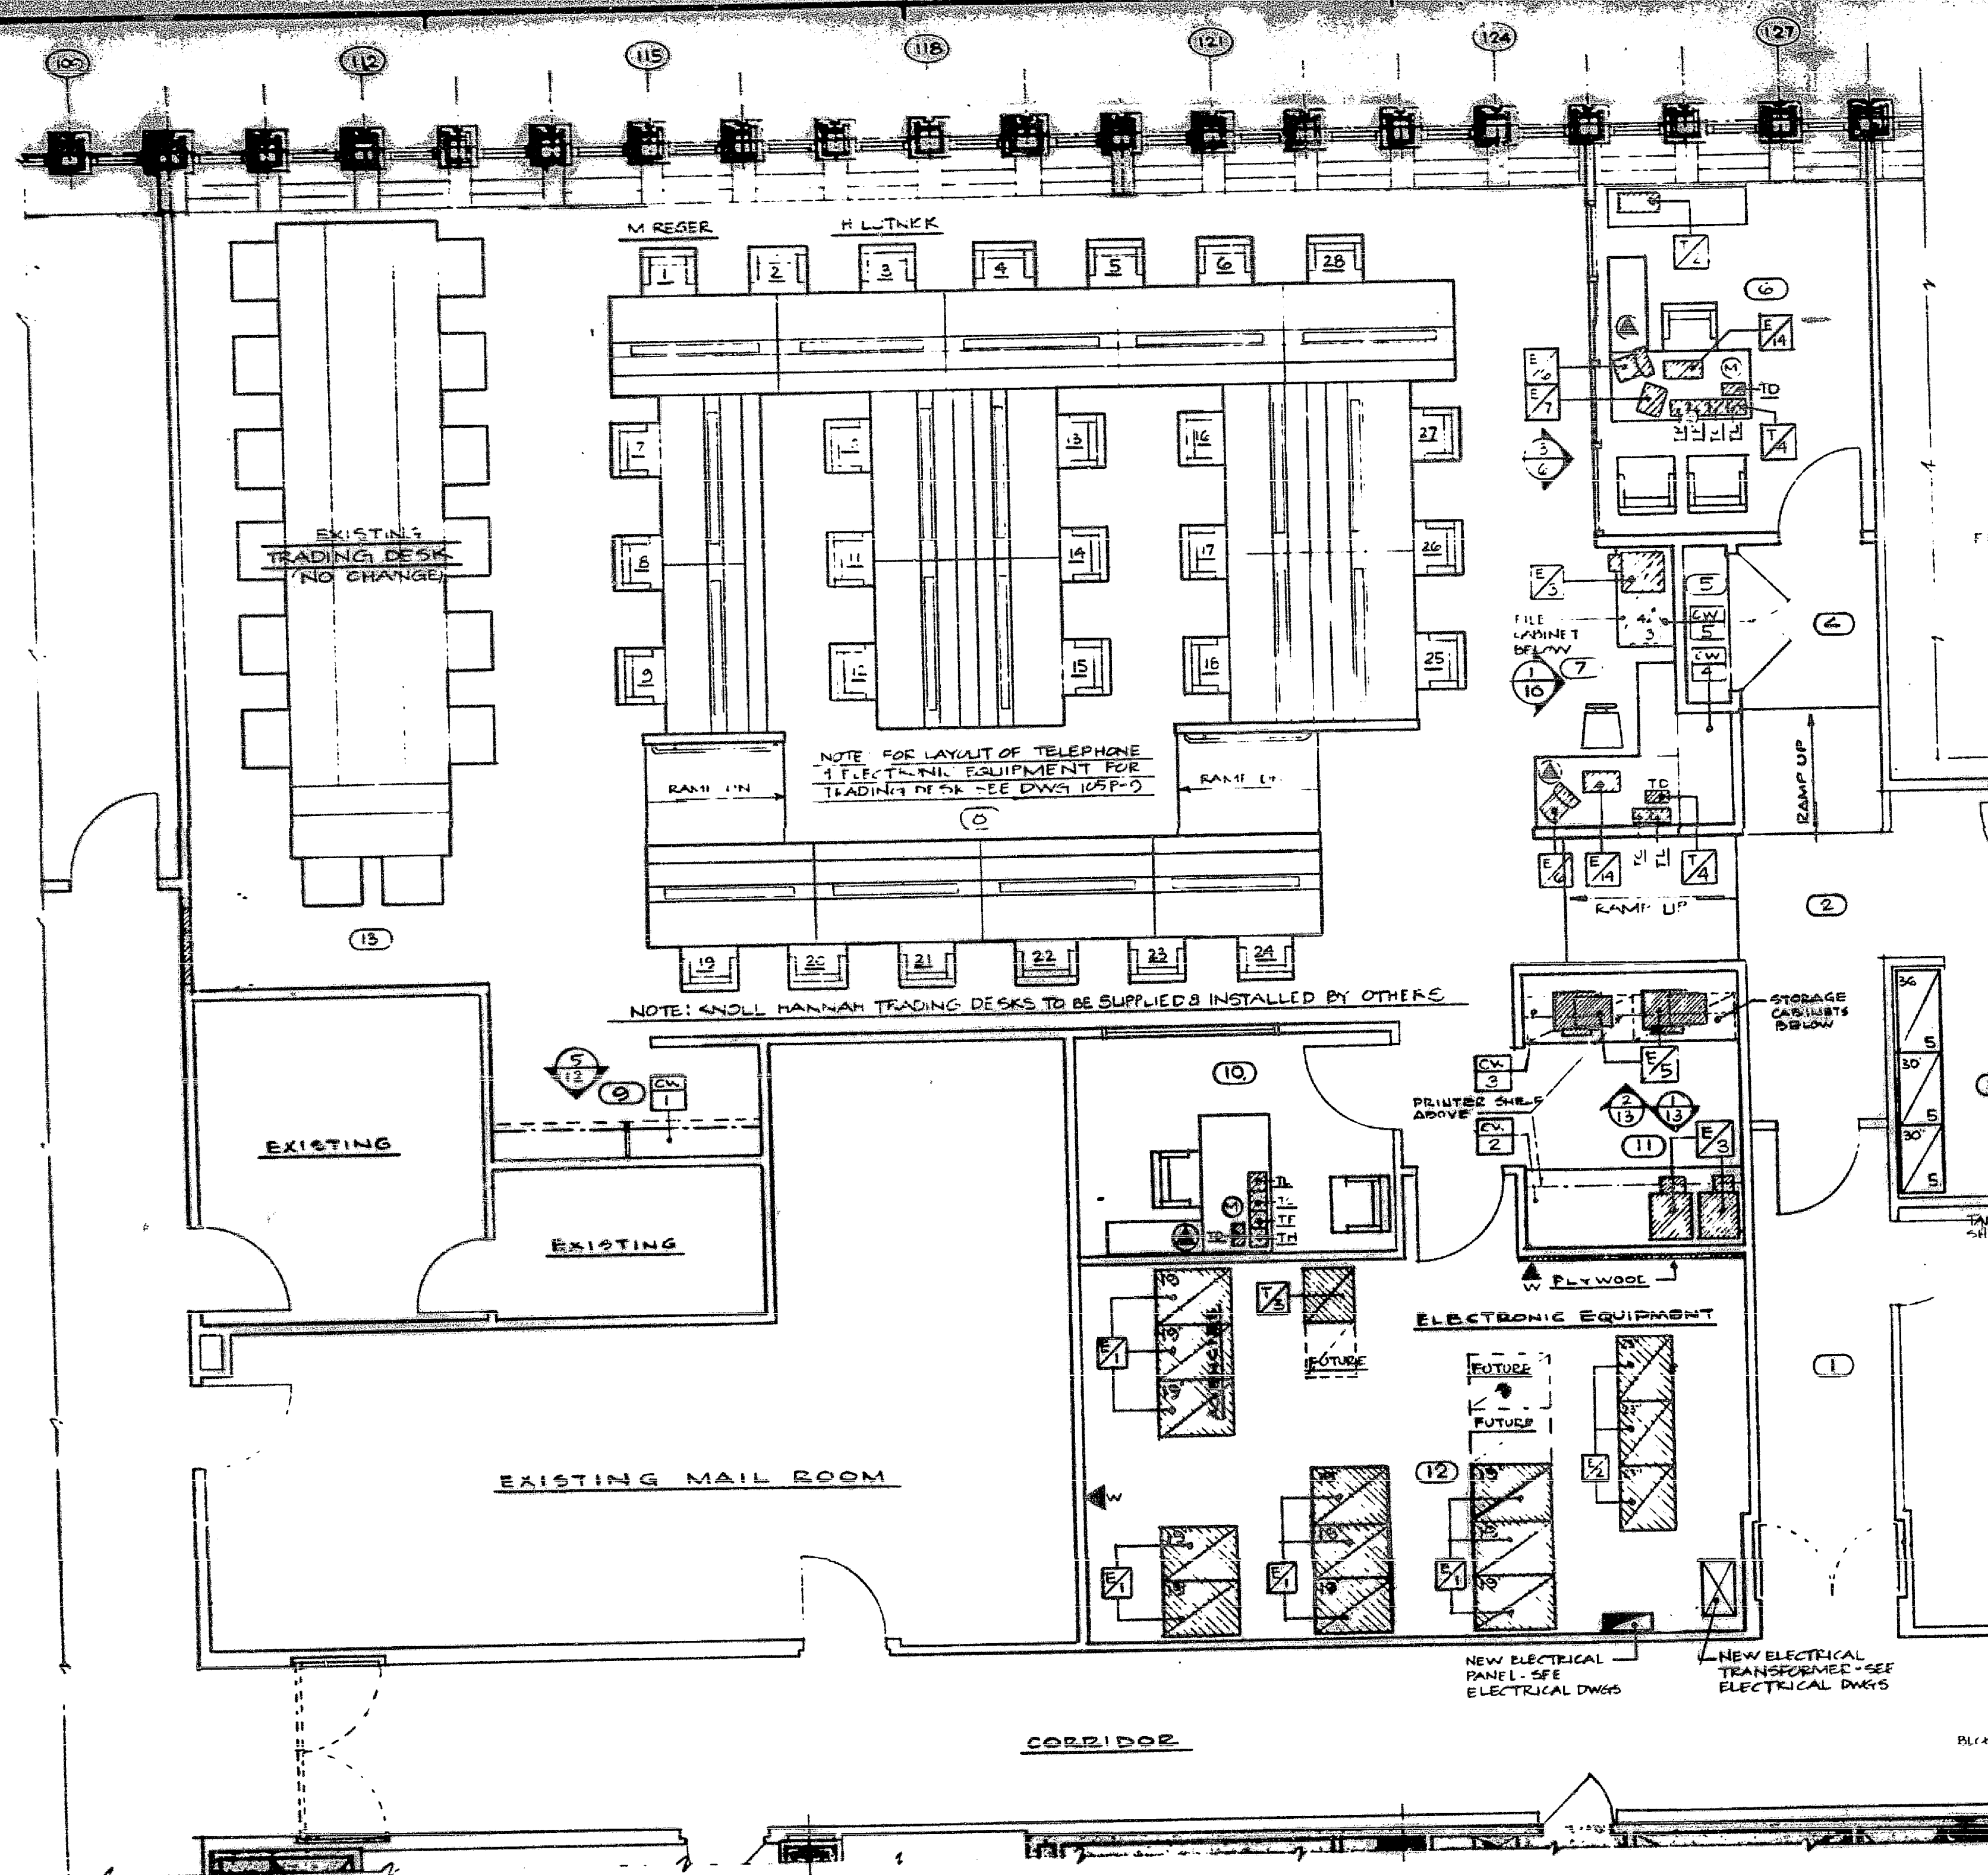

LEGEND

	SPACE NUMBER SYMBOL
	ELEV. NO. DWS NO. ELEVATION SYMBOL
	ELECTRONIC EQUIPMENT NO. SEE SCHEDULE THIS SHEET
	CAR NETWORK ITEM NUMBER SEE SCHEDULE
	ELECTRONIC EQUIPMENT
	LOCATION OF G BUTTON IN TELEPHONE INSTRUMENT
	LOCATION OF MICROPHONE FOR I.P.C. HOOT & HOLLER MODULE
	TELEPHONE SPEED DIALER MANUFACTURER & MODEL TO BE SELECTED BY C.F.S.C.
	WALL MTD. BUTTON K.V. SET

JUSTIN PC ARCHITECTS
205 LEXINGTON AVE
NEW YORK, NY 10016
TEL (212) 689 9550

JOHN C. WESTRICK & ASSOCIATES
CONSULTING ENGINEERS
210 MAPLE AVE. SOUTH PLAINFIELD, N.J.
07080 201 581-4370

DATE	ISSUED TO	PR	TH
3/22/91	FOR AUTHORITY'S APPROVAL	10	1
4/12/91	FOR C.F.S.C. REVIEW	5	4
4/18/91	FOR C.F.S.C. REVIEW	1	1
5/3/91	FOR APPROVAL	10	1
5/22/91	CDS MESTEL	5	1
5/24/91	CDS MESTEL	3	1
6/7/91	CDS	1	1
10/21/91	FOR AS BUILT DRAWING	1	1

AS BUILT DRAWING
Signature: [Signature] Date: 8-6-91
JUSTIN PC ARCHITECTS

NO	DATE	REVISION	BY
1	8-6-91	REVISED TO SHOW AS BUILT CONDITIONS	JFP

CANTOR, FITZGERALD SECURITIES CORP.
105TH FLOOR
ONE WORLD TRADE CENTER, NEW YORK, N.Y.

PROPOSED NEW TRADING ROOM FOR INVESTMENT STRATEGIES
FURNITURE & ELECTRONIC EQUIPMENT PLAN


PROJECT NO 706
SCALE 1/4" = 1'-0"
DRAWN BY JFP
CHECKED BY J.F.P.
DATE MARCH 20, 1991

DRAWING NO
105P
10

PART PLAN 105TH FLOOR
@ 1/4" = 1'-0"

ELECTRONIC EQUIPMENT SCHEDULE				
SYMBOL	DESCRIPTION MANUFACTURER OR SUPPLIER	MODEL NO.	ELECTRICAL REQUIREMENTS VOLTS AMPS WATTS OR KVA	REMARKS
E1	19" ELECTRONIC EQUIPMENT RACK	—	120 SEE REMARKS	PROVIDE (2) 20A CIRCUITS PER BACK FURNISHED BY C.F.S.C. SPACE NO. 12
E2	23" ELECTRONIC EQUIPMENT RACK	—	120 SEE REMARKS	PROVIDE (2) 20A CIRCUITS PER BACK FURNISHED BY C.F.S.C. SPACE NO. 12
E3	LASER JET PRINTER	SERIES II	115 7.0	—
E4	PRINTER	—	120 2.0	—
E5	FAX MACHINE	TELEPHONE 7050	120 5.0	—
E6	FIXED INCOME MONITOR	—	120 1.5 90W	—
E7	TELETYPE / SHARK MONITOR	—	120 .45	—
E8	FIXED INCOME KEYBOARD	—	—	—

TELEPHONE EQUIPMENT SCHEDULE				
SYMBOL	DESCRIPTION MANUFACTURER OR SUPPLIER	MODEL NO.	ELECTRICAL REQUIREMENTS VOLTS AMPS WATTS OR KVA	REMARKS
T1	TELEPHONE RECORDING PLAYBACK UNIT	1-PG-60-T-1	115V 15	— SPACE NO. 3
T2	REMOTE TELEPHONE RECORDING PLAYBACK UNIT	113008-01	115V 2	— SPACE NO. 6
T3	TELEPHONE RECORDING & PLAYBACK UNIT	4R/PGO	115V 6	— SPACE NO. 12
T4	I.P.C. SERIES II TELEPHONE MODULES INSTALLED IN I.P.C. DESKTOP ENCLOSURE	—	—	— SPACE NO. 6 & 7 SEE TELEPHONE LEGEND DWG 105P-9 FOR ABBREVIATIONS

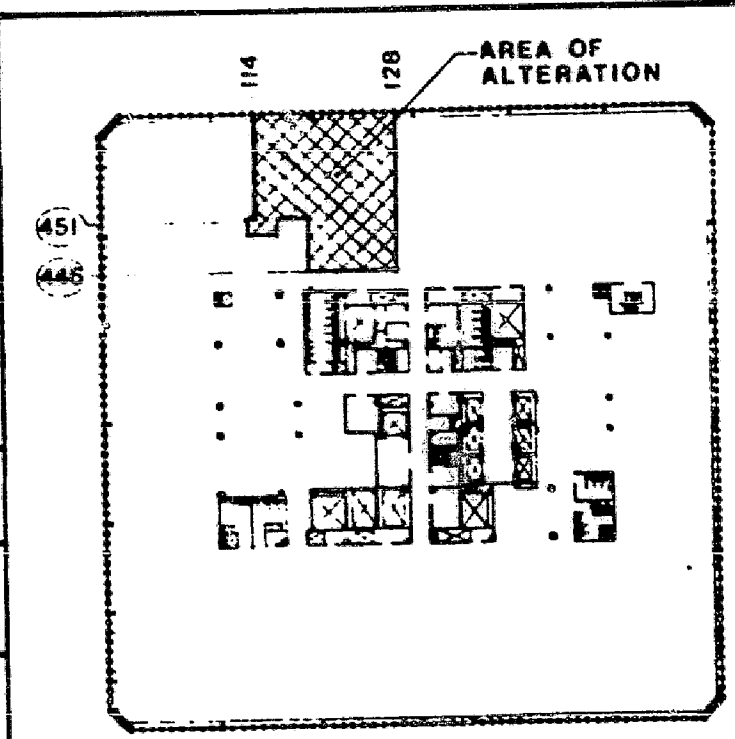

KEY PLAN
1/8" = 1'-0"

PHASE
P
TAA. NO. W91051

